


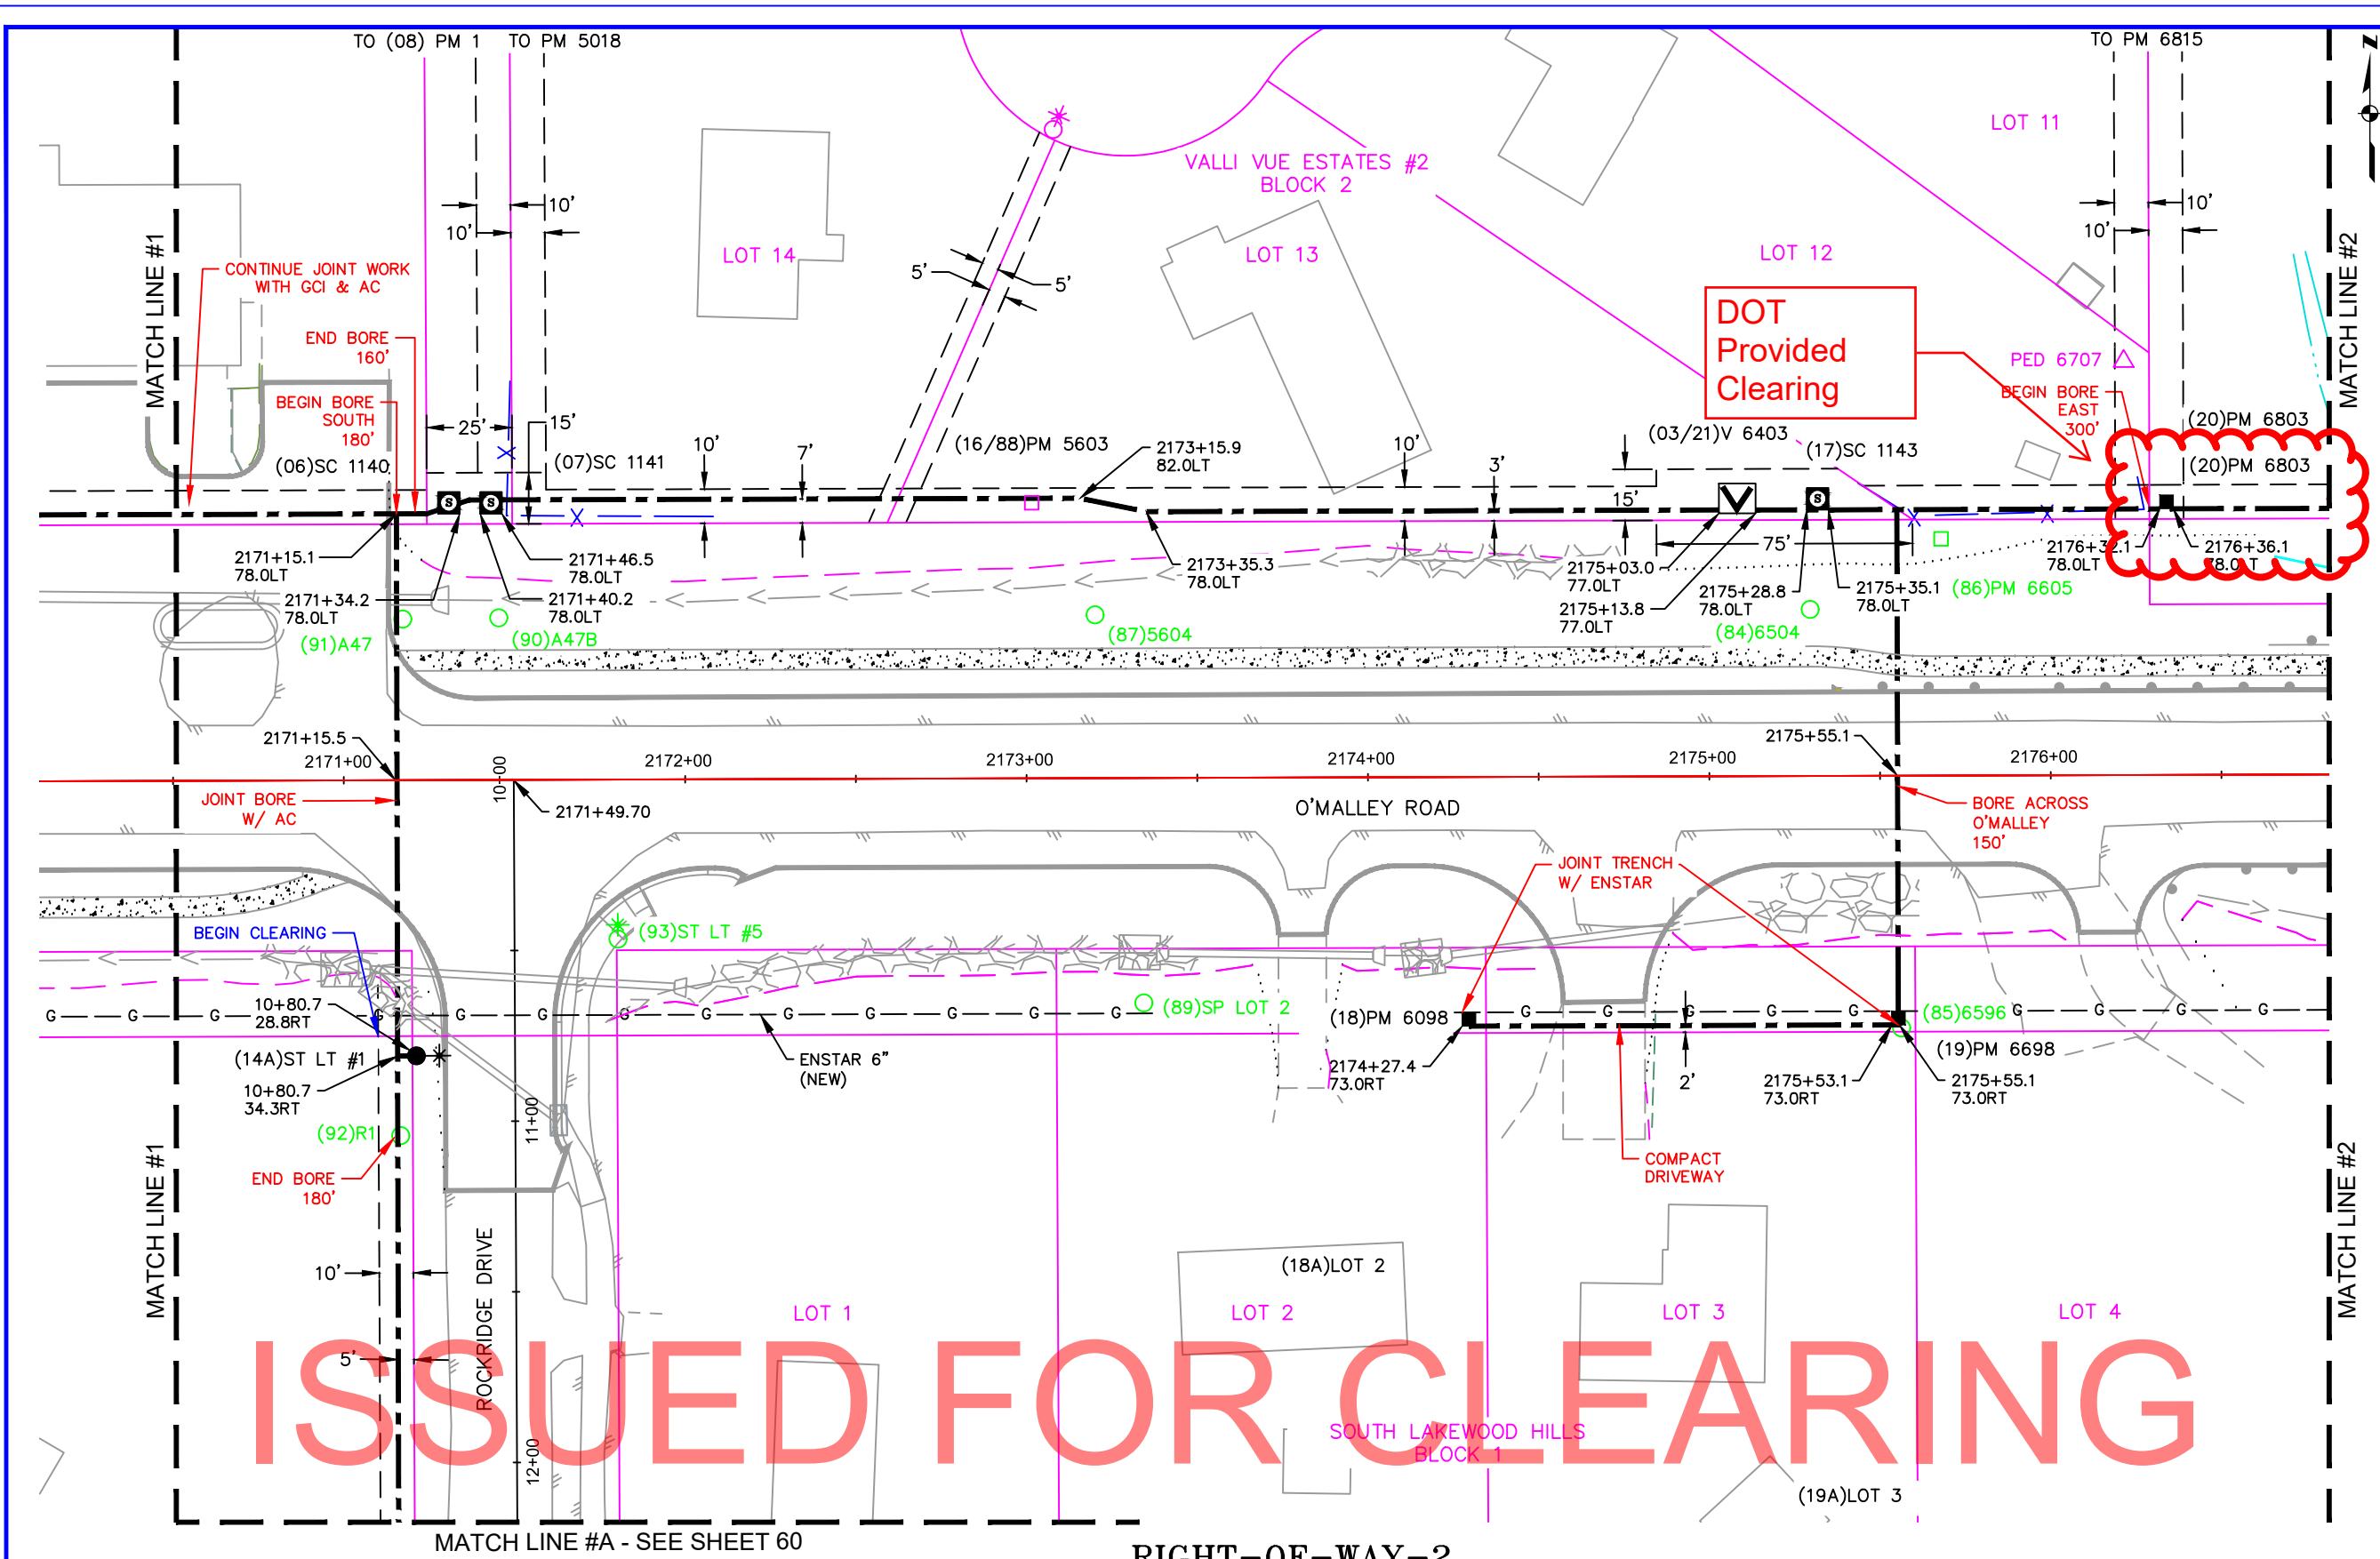

Vicinity Map
N.T.S.

CONDUCTOR DATA

Manuf. _____	Manuf. _____
Volt Rating _____	Volt Rating _____
Insul. Type _____	Insul. Type _____
Insul. Size _____	Insul. Size _____
Cond. Size/Type _____	Cond. Size/Type _____
Quantity in Feet _____	Quantity in Feet _____

Manuf. _____
Volt Rating _____
Insul. Type _____
Insul. Size _____
Cond. Size/Type _____
Quantity in Feet _____

CALL BEFORE YOU DIG!

LOCATE CALL CENTER OF ALASKA (LCCA)

ANCHORAGE AREA..... 278-3121

STATEWIDE..... 800-478-3121

AT&T ALASCOM INC..... 284-8465

ALASKA RAILROAD UTILITIES..... 265-2457

ALYESKA CABLE TV (GIRDWOOD)..... 783-2982

KULIS AIR BASE..... 249-1499

MILITARY PETROLEUM FUEL LINES..... 552-2334 OR 552-5342

STATE STORM DRAINS & STREET LIGHTS..... 333-2411

CONSTRUCTION LEGEND

NEW	EXISTING

R.O.W. LEGEND

R.O.W. LINE
CENTERLINE OF TRENCH

UNLESS OTHERWISE NOTED
CHUGACH FACILITIES WILL BE
INSTALLED AS SHOWN BELOW

TRENCH
PROPERTY LINE
UNDERGROUND

TRENCH
PROPERTY LINE
OVERHEAD

Typical Staking
N.T.S.

PROJECT: STATE OF ALASKA - O'MALLEY ROAD - 3Ø U.G. PRIMARY RELOCATION				
DESIGNER/PROJECT ENGINEER: M. ELLIOTT		W.O. #: E1913870		
NO.	DESIGN/CONSTRUCTION/ASBUILT REVISION	DWN BY/DATE	REVIEWED (MGR/SUPV)/DATE	APPROVED (DIRECTOR)/DATE
0	ISSUED FOR CONSTRUCTION	ME 03/25/21		

ENG. STAMP

CHUGACH
POWERING ALASKA'S FUTURE

Chugach Electric Association, Inc.
5601 Minnesota Drive - P.O. Box 196300
Anchorage, Alaska 99519-6300


DRAWING NAME:

STATE OF ALASKA - O'MALLEY ROAD
3Ø U.G. PRIMARY RELOCATION
GRID: 2538, 2539, 2638, 2639 MAP: 1203-14C&D, 1203-23A&B
FEEDER: O'MALLEY 212 & 312

W.O. NO.:
C.W.P. REF. NO.:

E1913870

SHEET 62 OF 93

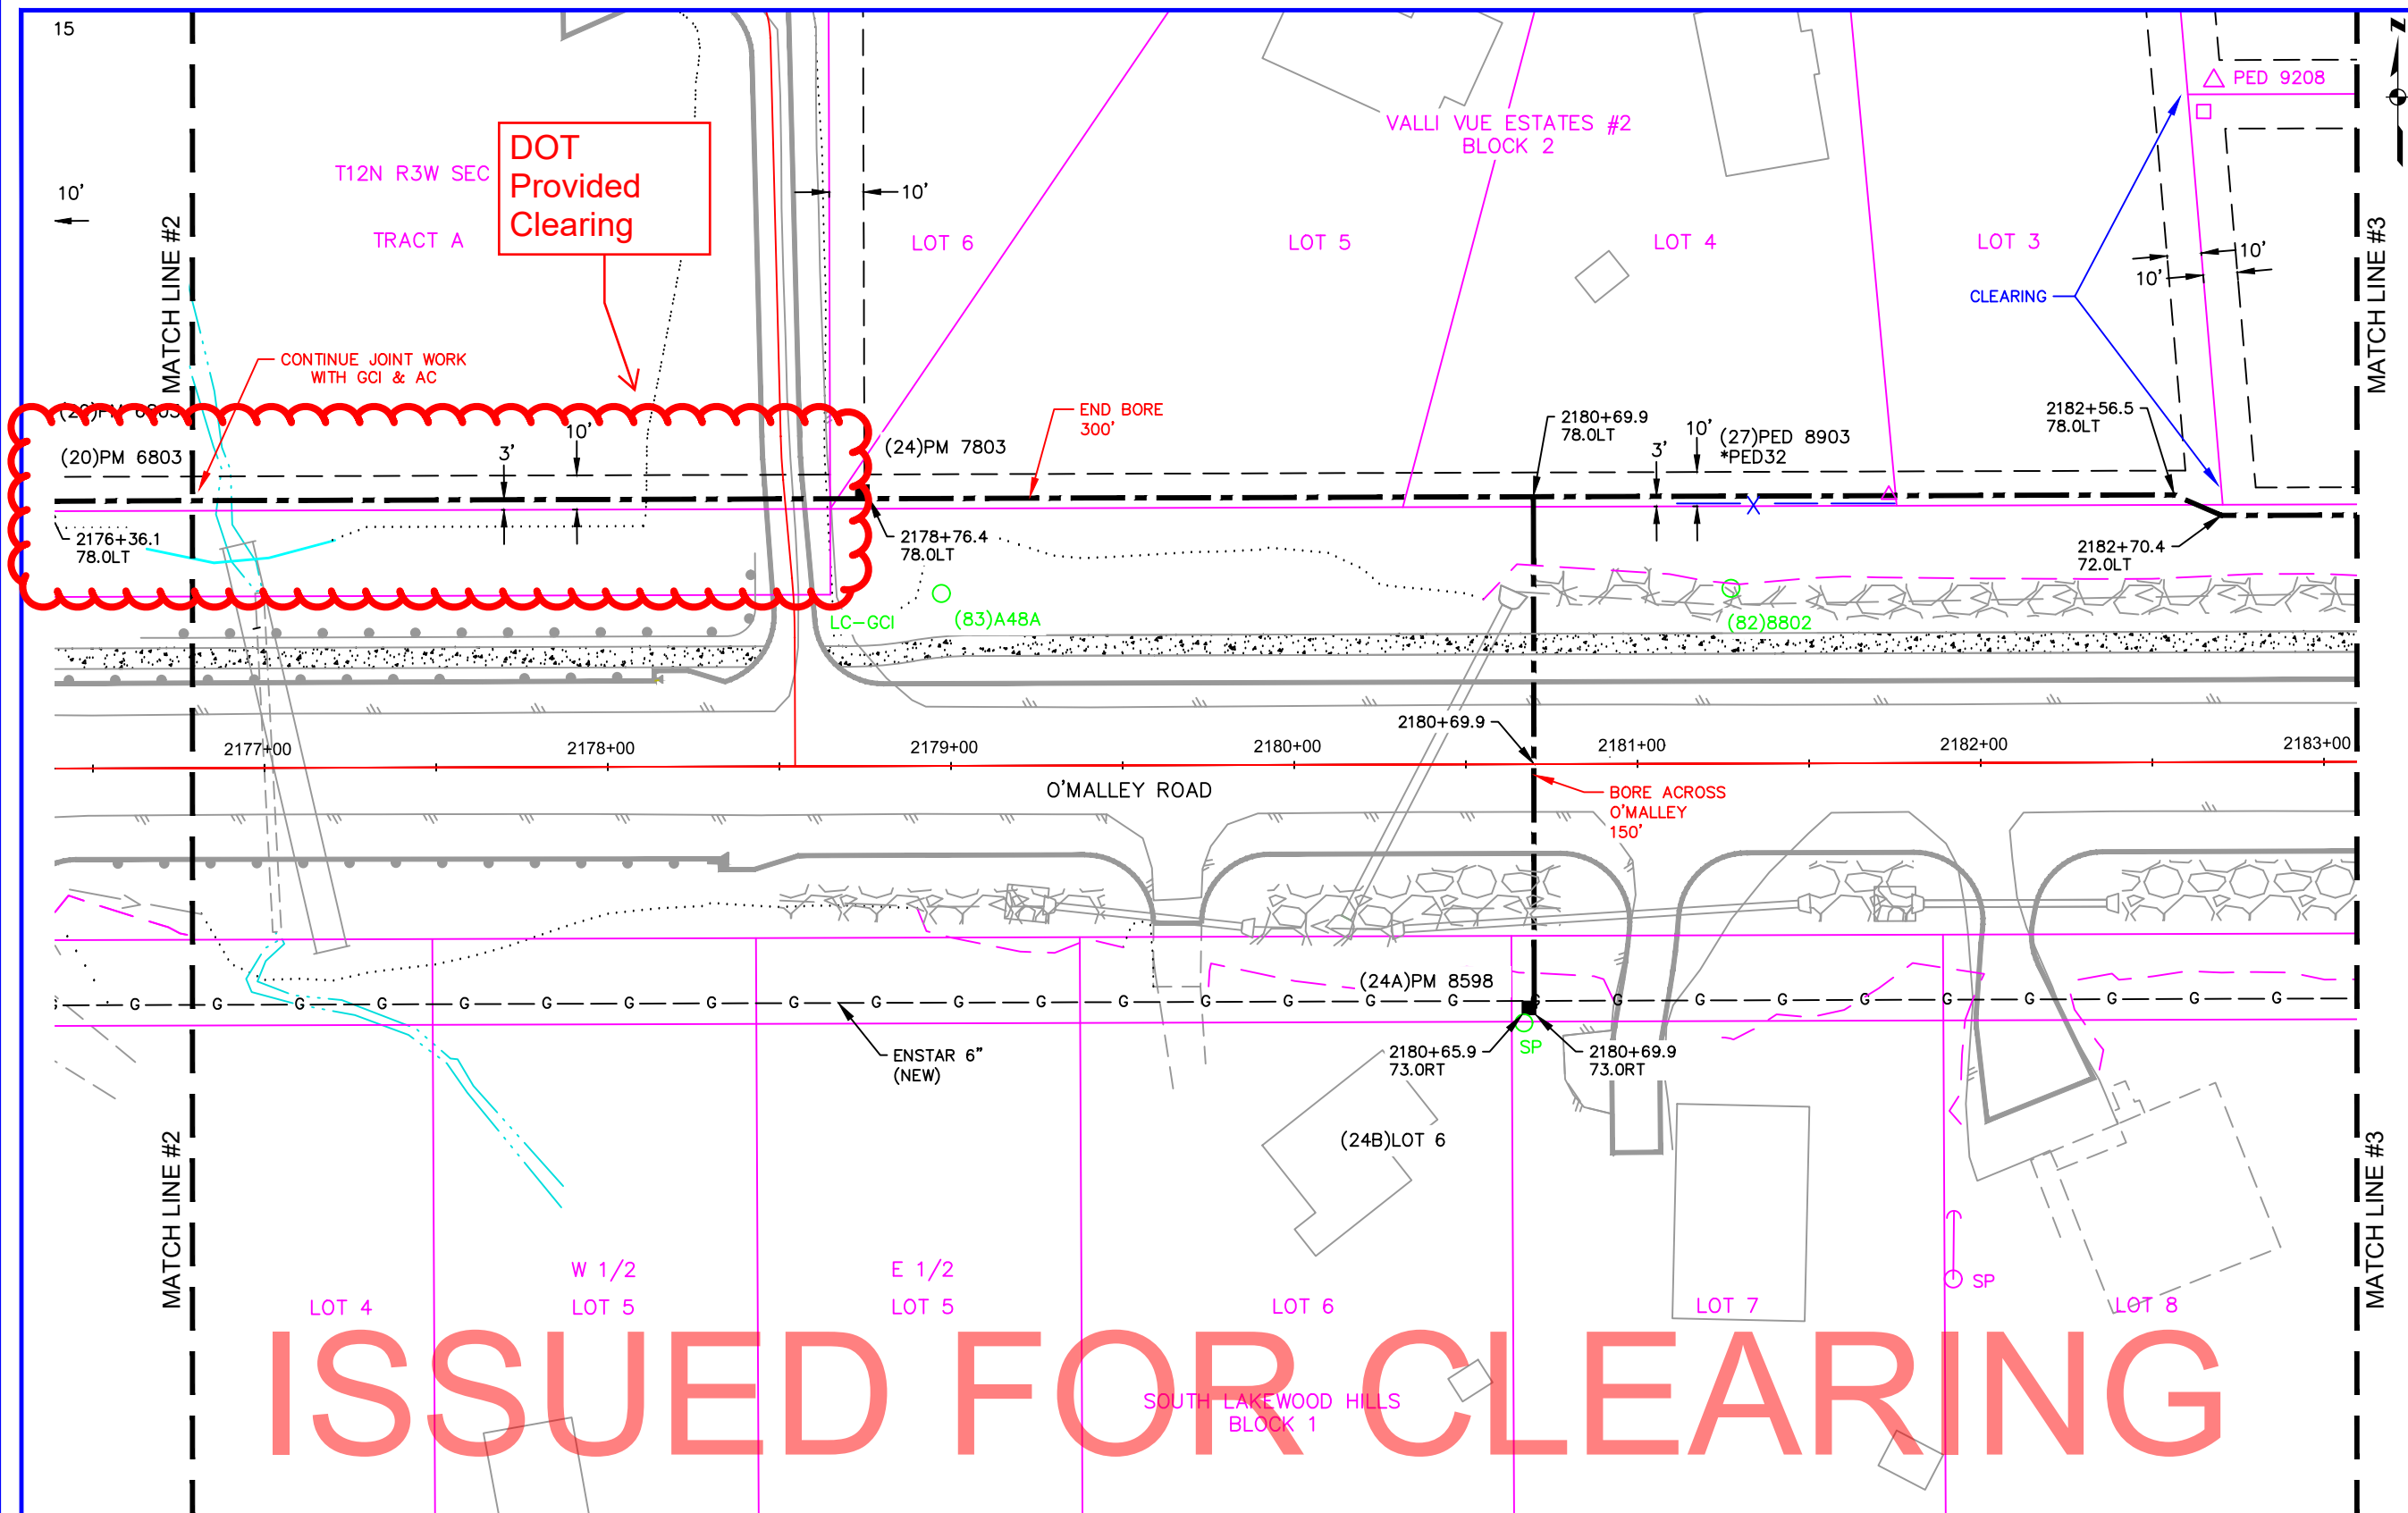

Vicinity Map
N.T.S.

CONDUCTOR DATA			
Manuf.	Manuf. Date	Manuf.	Manuf. Date
Volt Rating	Volt Rating	Insul. Type	Insul. Type
Insul. Size	Insul. Size	Cond. Size/Type	Cond. Size/Type
Quantity in Feet	Quantity in Feet	Quantity in Feet	Quantity in Feet


CALL BEFORE YOU DIG!

LOCATE CALL CENTER OF ALASKA (LCCA)
ANCHORAGE AREA..... 278-3121
STATEWIDE..... 800-478-3121
AT&T ALASCOM INC..... 284-8465
ALASKA RAILROAD UTILITIES..... 265-2457
ALYESKA CABLE TV (GIRDWOOD)..... 783-2982
KULIS AIR BASE..... 249-1499
MILITARY PETROLEUM FUEL LINES..... 552-2334
OR 552-5342
STATE STORM DRAINS & STREET LIGHTS..... 333-2411

CONSTRUCTION LEGEND

NEW	EXISTING

R.O.W. LEGEND

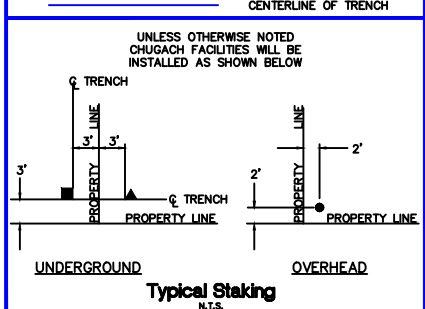


PROJECT: STATE OF ALASKA - O'MALLEY ROAD - 30 U.G. PRIMARY RELOCATION				
DESIGNER/PROJECT ENGINEER: M. ELLIOTT				
W.O. #: E1913870				
NO.	DESIGN/CONSTRUCTION/ASBUILT REVISION	DWN BY/DATE	REVIEWED (MGR/SUPV)/DATE	APPROVED (DIRECTOR)/DATE
0	ISSUED FOR CONSTRUCTION	ME 03/25/21		

ENG. STAMP

CHUGACH
POWERING ALASKA'S FUTURE

Chugach Electric Association, Inc.
5601 Minnesota Drive - P.O. Box 196300
Anchorage, Alaska 99519-6300

DRAWING NAME:	STATE OF ALASKA - O'MALLEY ROAD 30 U.G. PRIMARY RELOCATION GRID: 2538, 2539, 2638, 2639 MAP: 1203-14C&D, 1203-23A&B FEEDER: O'MALLEY 212 & 312
W.O. NO:	E1913870
C.W.P. REF. NO:	
SHEET	63 OF 93

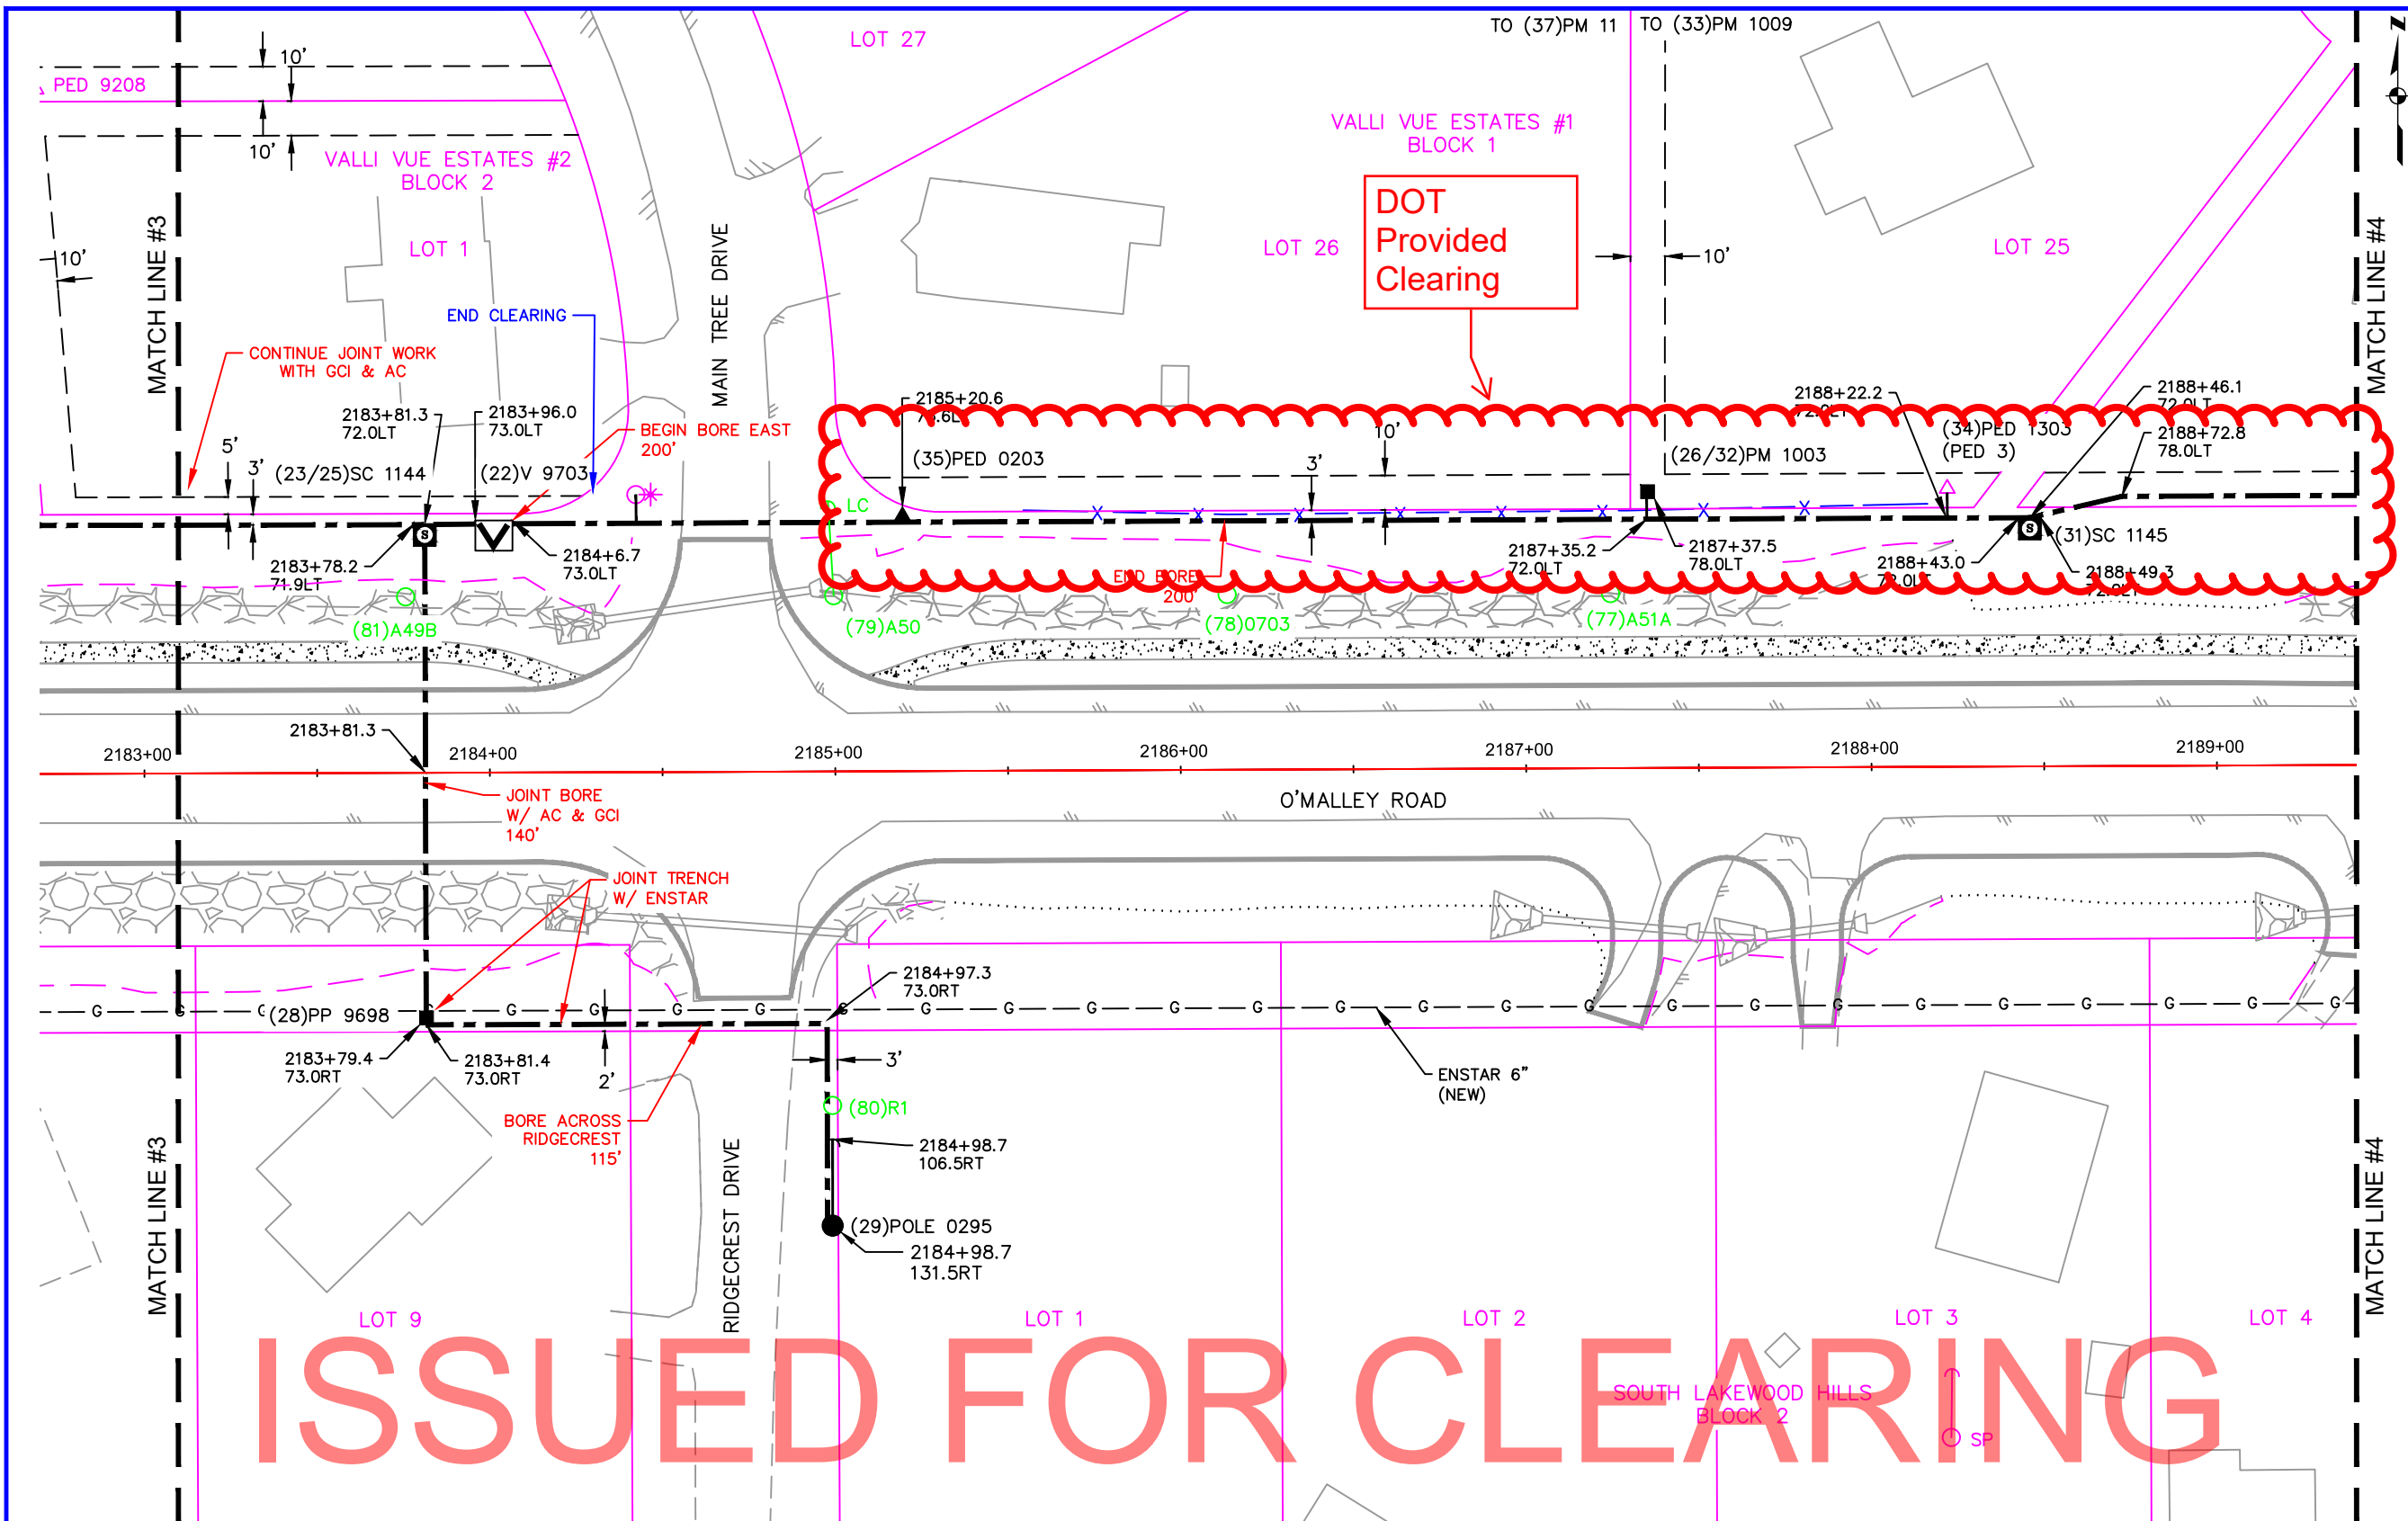

RIGHT-OF-WAY-4

Vicinity Map
N.T.S.

CONDUCTOR DATA

Manuf. _____	Manuf. _____
Volt Rating _____	Volt Rating _____
Insul. Type _____	Insul. Type _____
Insul. Size _____	Insul. Size _____
Cond. Size/Type _____	Cond. Size/Type _____
Quantity in Feet _____	Quantity in Feet _____

CALL BEFORE YOU DIG!

LOCATE CALL CENTER OF ALASKA (LCCA)

ANCHORAGE AREA..... 278-3121

STATEWIDE..... 800-478-3121

AT&T ALASCOM INC. 284-8465

ALASKA RAILROAD UTILITIES..... 265-2457

ALYESKA CABLE TV (GIRDWOOD)..... 783-2982

KULIS AIR BASE..... 249-1499

MILITARY PETROLEUM FUEL LINES..... 552-2334 OR 552-5342

STATE STORM DRAINS & STREET LIGHTS..... 333-2411

CONSTRUCTION LEGEND

NEW	EXISTING

R.O.W. LEGEND

R.O.W. LINE _____

CENTERLINE OF TRENCH _____

UNLESS OTHERWISE NOTED
CHUGACH FACILITIES WILL BE
INSTALLED AS SHOWN BELOW

TRENCH

PROPERTY LINE

UNDERGROUND

PROPERTY LINE

OVERHEAD

Typical Staking
N.T.S.

PROJECT: STATE OF ALASKA - O'MALLEY ROAD - 30 U.G. PRIMARY RELOCATION				
DESIGNER/PROJECT ENGINEER: M. ELLIOTT		W.O. #: E1913870		
NO.	DESIGN/CONSTRUCTION/ASBUILT REVISION	DWN BY/DATE	REVIEWED (MGR/SUPV)/DATE	APPROVED (DIRECTOR)/DATE
0	ISSUED FOR CONSTRUCTION	ME 03/25/21		

ENG. STAMP

CHUGACH
POWERING ALASKA'S FUTURE

Chugach Electric Association, Inc.
5601 Minnesota Drive - P.O. Box 196300
Anchorage, Alaska 99519-6300


DRAWING NAME:

STATE OF ALASKA - O'MALLEY ROAD
30 U.G. PRIMARY RELOCATION
GRID: 2538, 2539, 2638, 2639 MAP: 1203-14C&D, 1203-23A&B
FEEDER: O'MALLEY 212 & 312

W.O. NO.:
C.W.P. REF. NO.:

E1913870

SHEET 64 OF 93

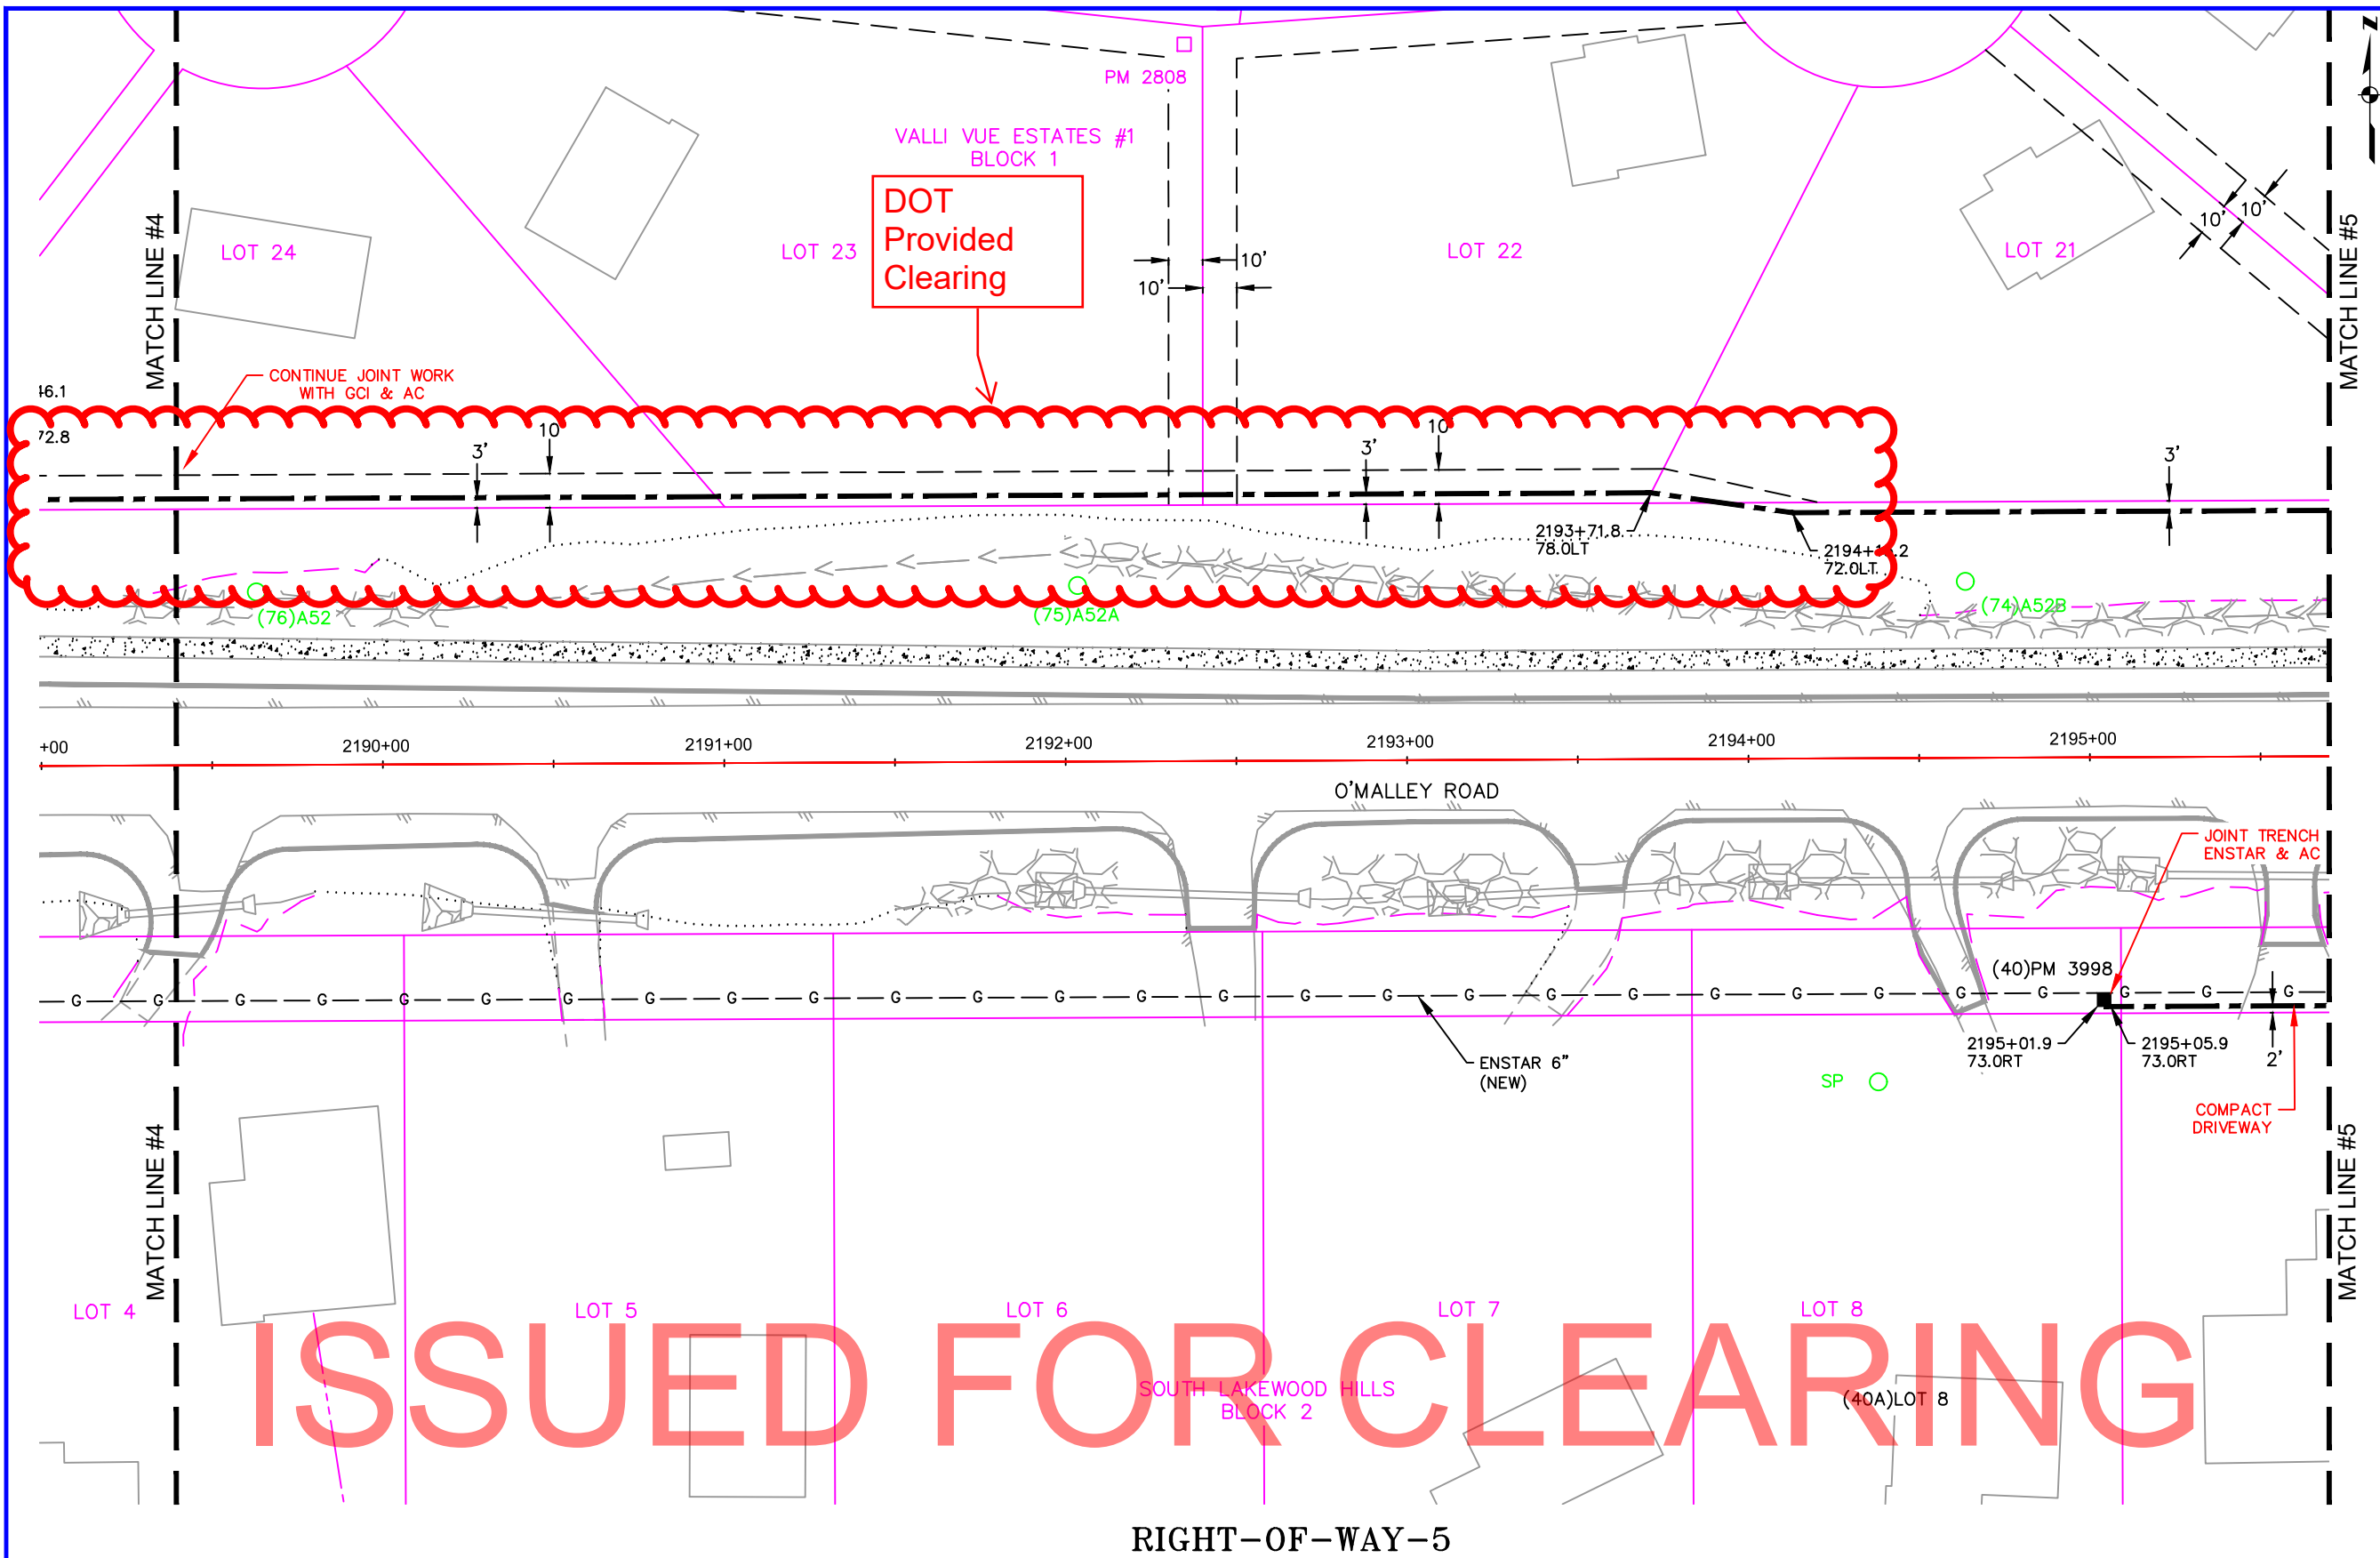

Vicinity Map
N.T.S.

CONDUCTOR DATA			
Manuf.	Manuf. Date	Manuf.	Manuf. Date
Volt Rating	Volt Rating	Insul. Type	Insul. Type
Insul. Size	Insul. Size	Cond. Size/Type	Cond. Size/Type
Quantity in Feet	Quantity in Feet	Quantity in Feet	Quantity in Feet
Manuf.	Manuf. Date	Manuf.	Manuf. Date
Volt Rating	Volt Rating	Insul. Type	Insul. Type
Insul. Size	Insul. Size	Cond. Size/Type	Cond. Size/Type
Quantity in Feet	Quantity in Feet	Quantity in Feet	Quantity in Feet

CALL BEFORE YOU DIG!


LOCATE CALL CENTER OF ALASKA (LCCA)
ANCHORAGE AREA..... 278-3121
STATEWIDE..... 800-478-3121
AT&T ALASCOM INC..... 284-8465
ALASKA RAILROAD UTILITIES..... 265-2457
ALYESKA CABLE TV (GIRDWOOD)..... 783-2982
KULIS AIR BASE..... 249-1499
MILITARY PETROLEUM FUEL LINES..... 552-2334
OR 552-5342
STATE STORM DRAINS & STREET LIGHTS..... 333-2411

CONSTRUCTION LEGEND

NEW	EXISTING

R.O.W. LEGEND

R.O.W. LINE
CENTERLINE OF TRENCH

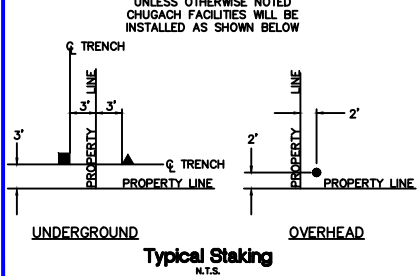

PROJECT: STATE OF ALASKA - O'MALLEY ROAD - 30 U.G. PRIMARY RELOCATION				
DESIGNER/PROJECT ENGINEER: M. ELLIOTT				
W.O. #: E1913870				
NO.	DESIGN/CONSTRUCTION/ASBUILT REVISION	DWN BY/DATE	REVIEWED (MGR/SUPV)/DATE	APPROVED (DIRECTOR)/DATE
0	ISSUED FOR CONSTRUCTION	ME 03/25/21		

ENG. STAMP

CHUGACH
POWERING ALASKA'S FUTURE

Chugach Electric Association, Inc.
5601 Minnesota Drive - P.O. Box 196300
Anchorage, Alaska 99519-6300


DRAWING NAME:

STATE OF ALASKA - O'MALLEY ROAD
30 U.G. PRIMARY RELOCATION
GRID: 2538, 2539, 2638, 2639 MAP: 1203-14C&D, 1203-23A&B
FEEDER: O'MALLEY 212 & 312

W.O. NO.:
C.W.P. REF. NO.:

E1913870

SHEET 65 OF 93

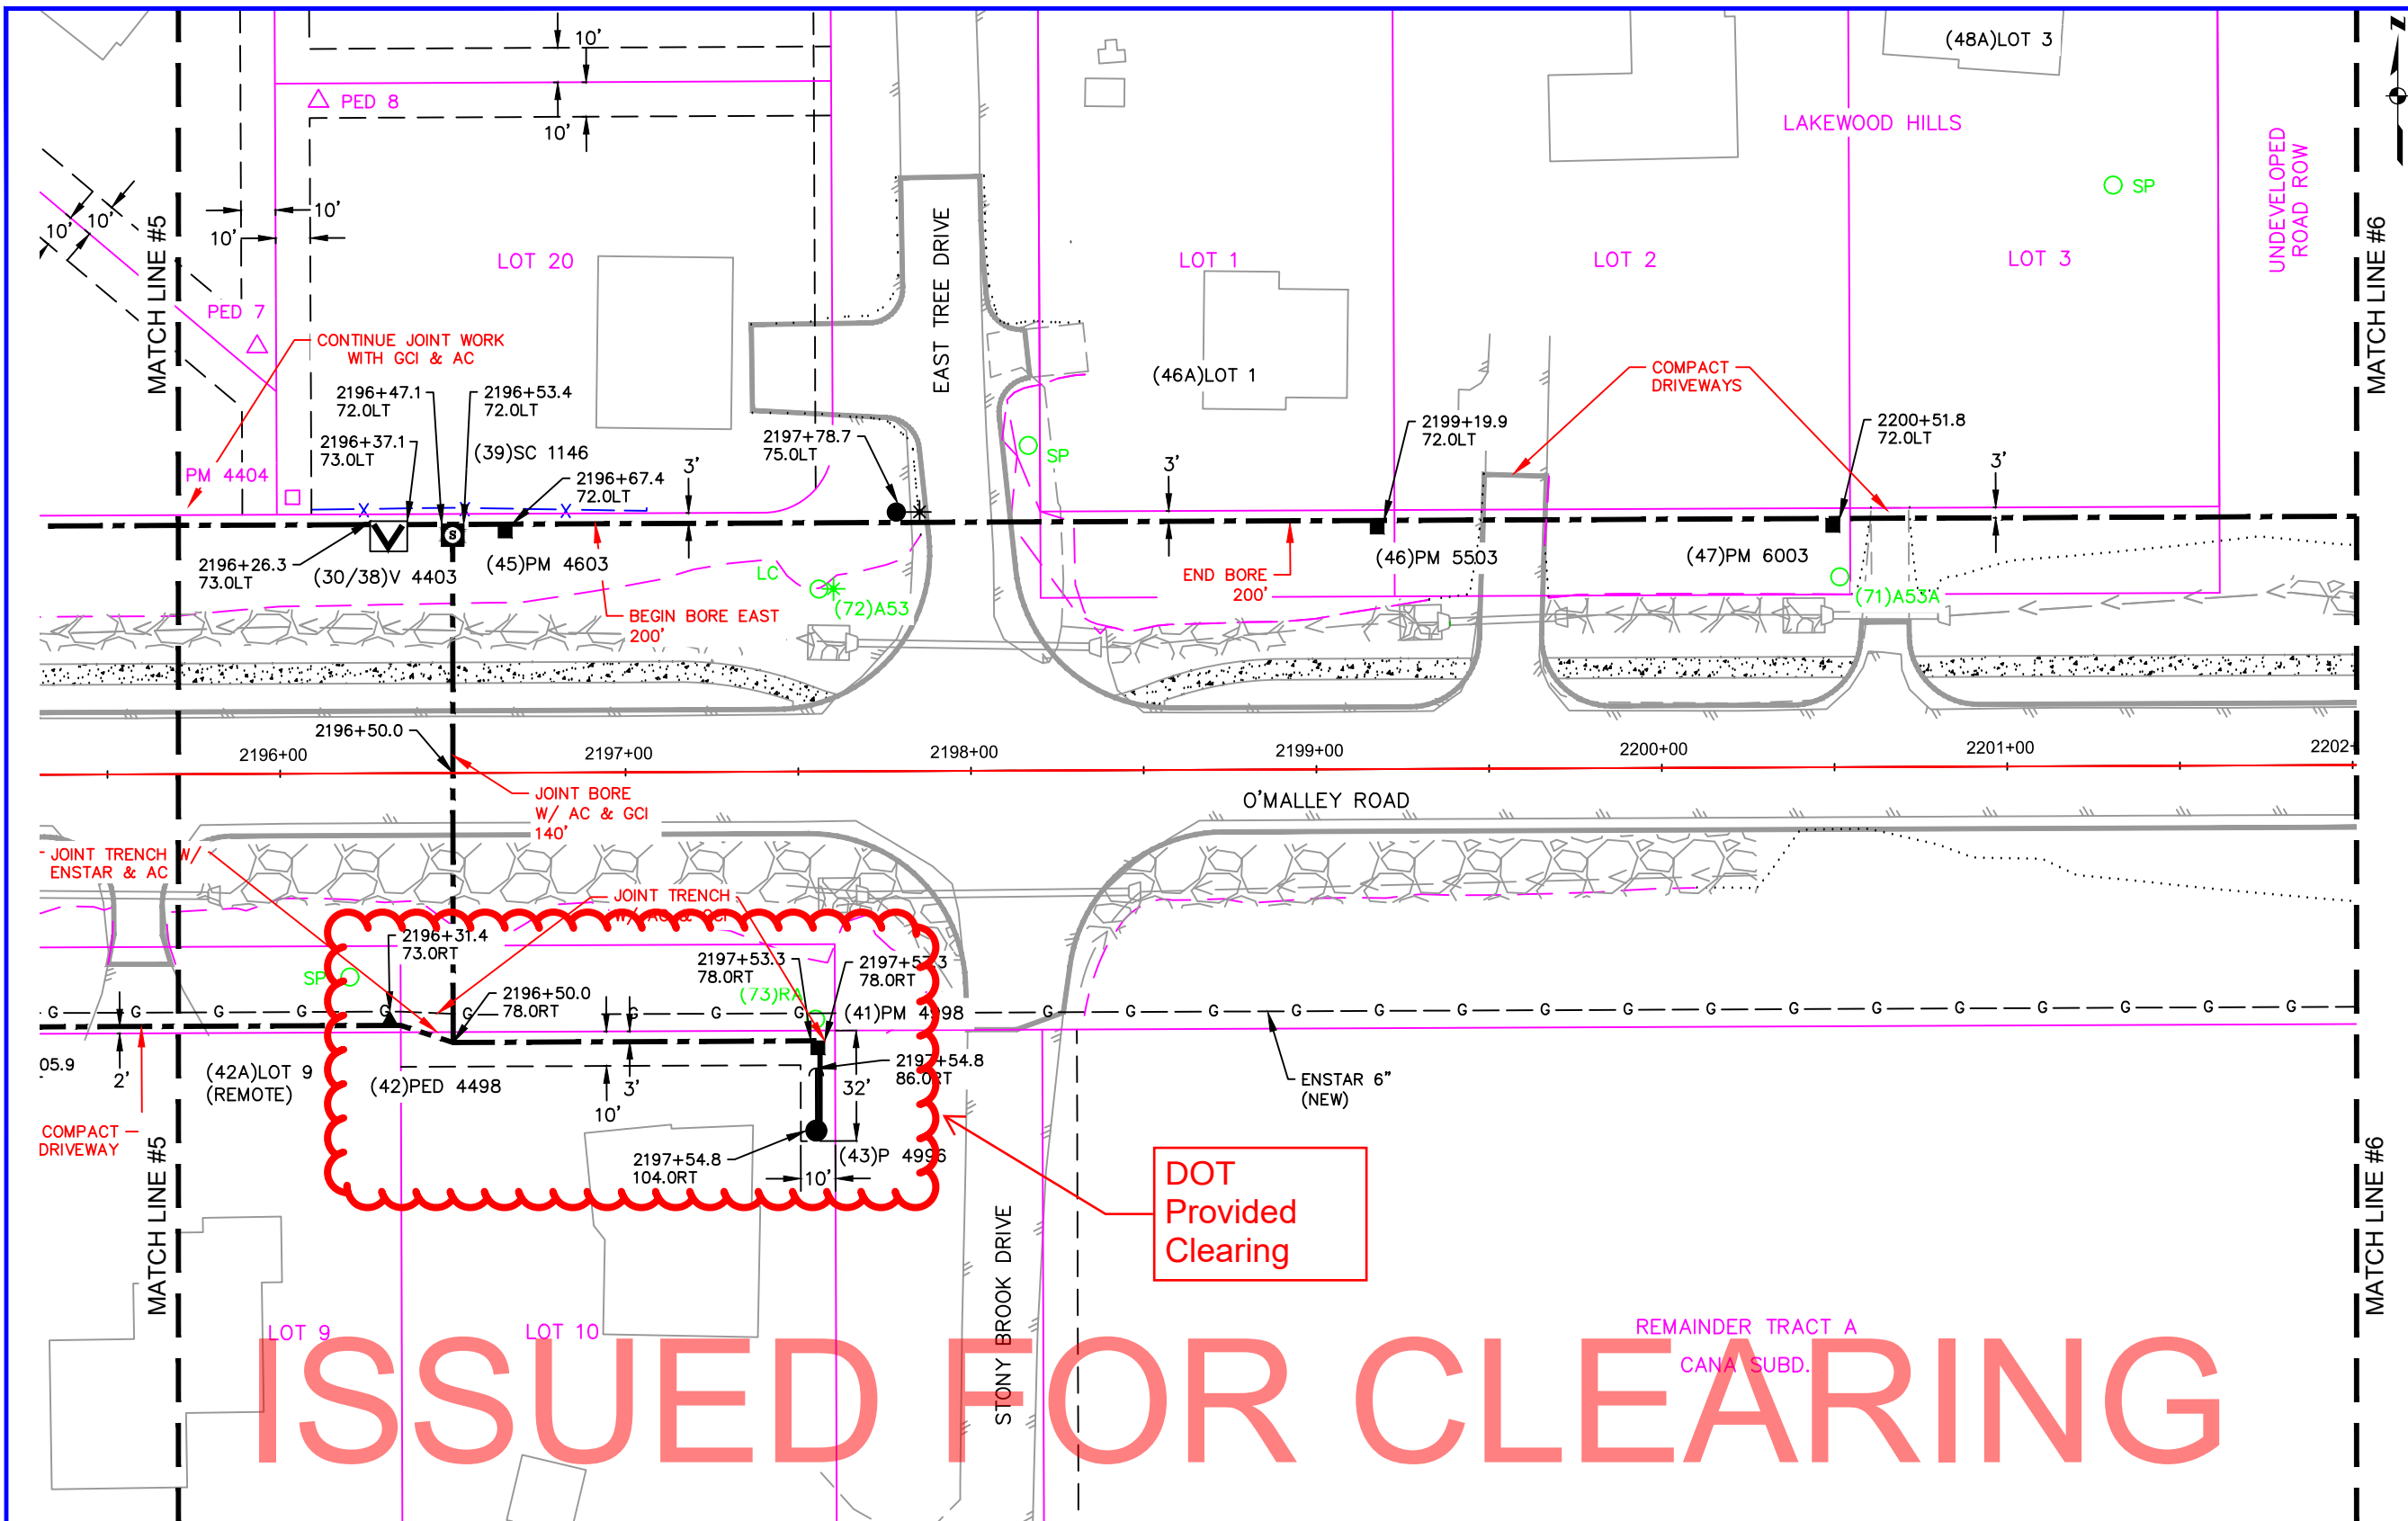

Vicinity Map
N.T.S.

CONDUCTOR DATA

Manuf. _____	Manuf. _____
Volt Rating _____	Volt Rating _____
Insul. Type _____	Insul. Type _____
Insul. Size _____	Insul. Size _____
Cond. Size/Type _____	Cond. Size/Type _____
Quantity in Feet _____	Quantity in Feet _____

CALL BEFORE YOU DIG!

LOCATE CALL CENTER OF ALASKA (LCCA)

ANCHORAGE AREA.....	278-3121
STATEWIDE.....	800-478-3121
AT&T ALASCOM INC.....	284-8465
ALASKA RAILROAD UTILITIES.....	265-2457
ALYESKA CABLE TV (GIRDWOOD).....	783-2982
KULIS AIR BASE.....	249-1499
MILITARY PETROLEUM FUEL LINES.....	552-2334
	OR 552-5342
STATE STORM DRAINS & STREET LIGHTS.....	333-2411

CONSTRUCTION LEGEND

NEW	EXISTING

R.O.W. LEGEND

R.O.W. LINE
CENTERLINE OF TRENCH

UNLESS OTHERWISE NOTED
CHUGACH FACILITIES WILL BE
INSTALLED AS SHOWN BELOW

Typical Staking
N.T.S.

PROJECT: STATE OF ALASKA - O'MALLEY ROAD - 30 U.G. PRIMARY RELOCATION				
DESIGNER/PROJECT ENGINEER: M. ELLIOTT		W.O. #: E1913870		
NO.	DESIGN/CONSTRUCTION/ASBUILT REVISION	DWN BY/DATE	REVIEWED (MGR/SUPV)/DATE	APPROVED (DIRECTOR)/DATE
0	ISSUED FOR CONSTRUCTION	ME 03/25/21		

ENG. STAMP

CHUGACH
POWERING ALASKA'S FUTURE

Chugach Electric Association, Inc.
5601 Minnesota Drive - P.O. Box 196300
Anchorage, Alaska 99519-6300

DRAWING NAME: STATE OF ALASKA - O'MALLEY ROAD
30 U.G. PRIMARY RELOCATION
GRID: 2538, 2539, 2638, 2639 MAP: 1203-14C&D, 1203-23A&B
FEEDER: O'MALLEY 212 & 312

W.O. NO.: E1913870
C.W.P. REF. NO.: SHEET 66 OF 93